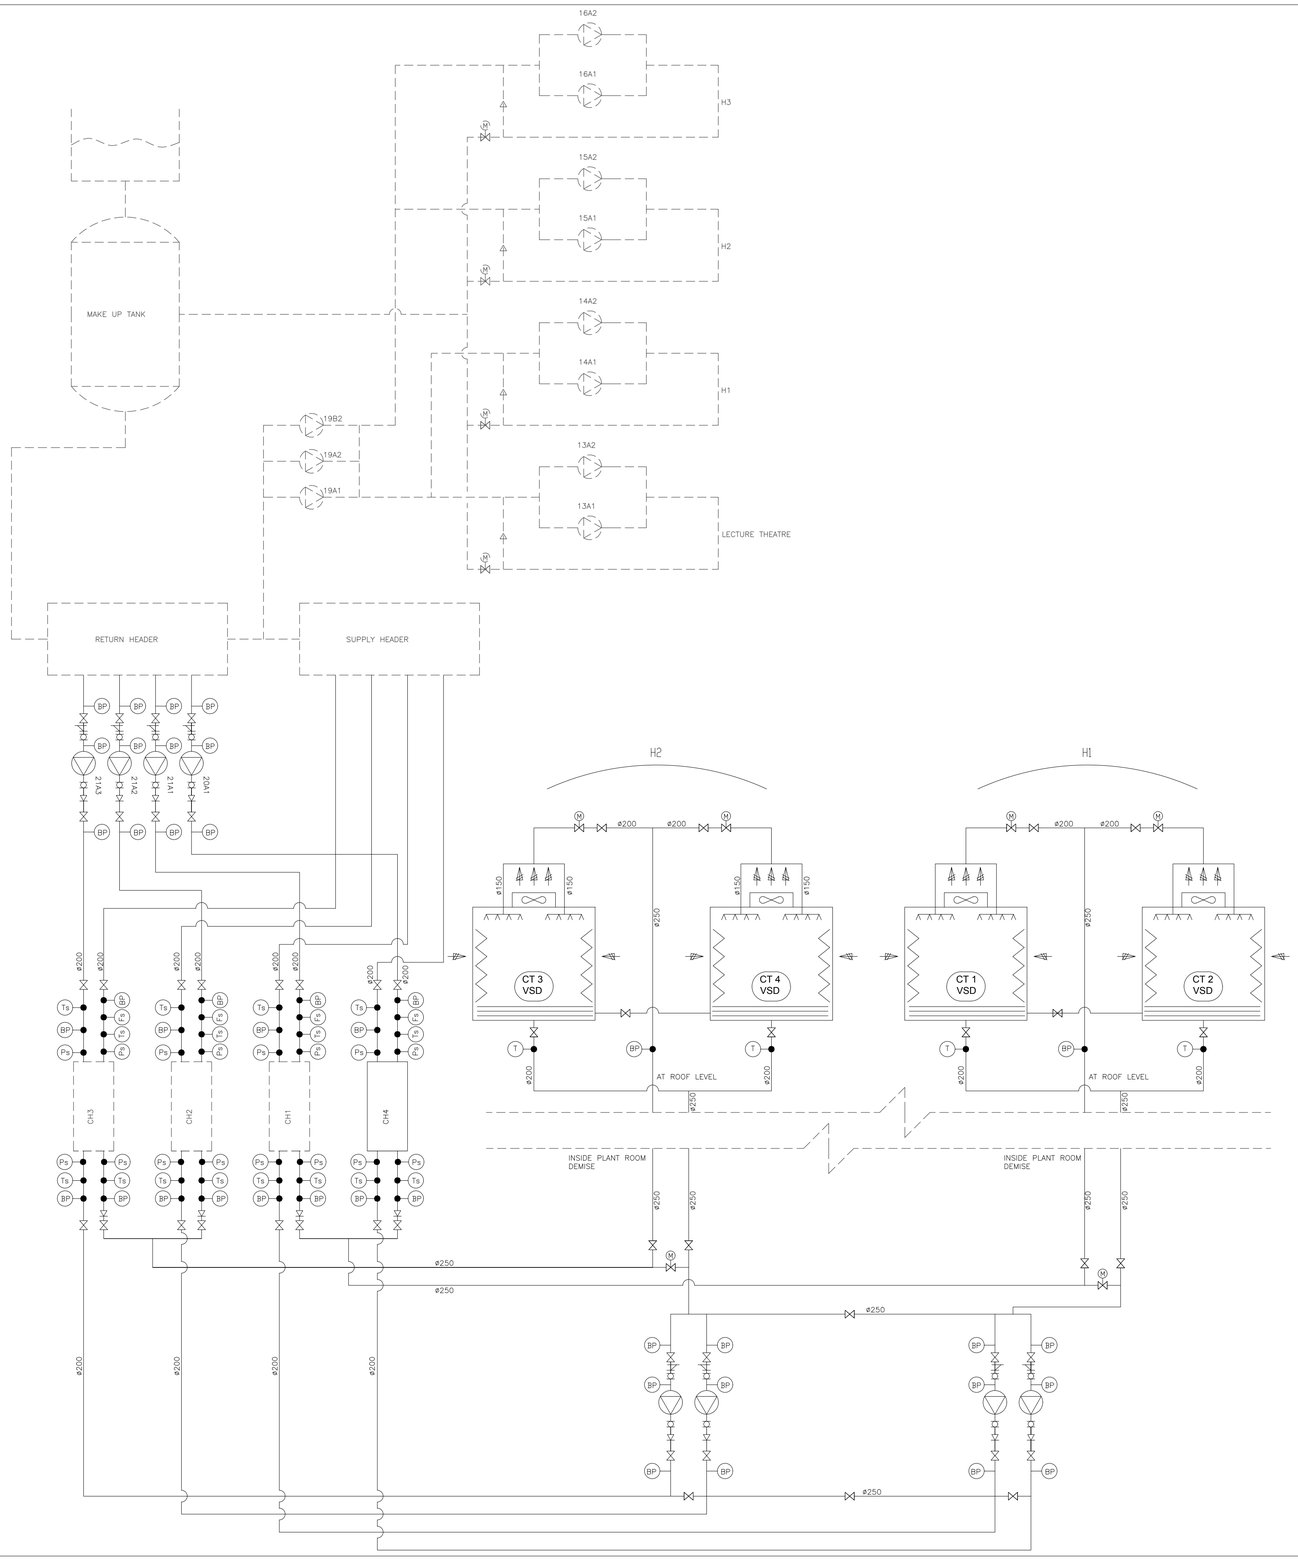

No	Date	Details	By
1	16/10/17	AS BUILD	JR
0	19/12/16	ISSUED FOR APPROVAL	JR

Revisions

This drawing is issued on the strict understanding that all information contained herein will be treated as confidential and not used without permission.

Eng. Sign

Drawn	Checked	Engineer
JR		JF

Scale	Date
NTS	19/12/16

Reference No	Dwg No	Rev
AC 108793	5	1

Project

GROOTE SCHUUR HOSPITAL

Description

As-built schematic of existing system

Tender No.: WCGHIC0001/2026

Drawing 3