LEGEND

- UNDERGROUND PRODUCT PIPELINES
- DECOMMISSIONED UNDERGROUND PRODUCT PIPELINES
- EXISTING UNDERGROUND FIRE WATER PIPES
- EXISTING UNDERGROUND FOAM PREMIX PIPES

SITE SURVEY DATE 2025/07

DESIGNER			
RESP. ENG			
PROJ. MANAGER			
CLIENT			
ROLE	NAME	SIGN	DATE
DRAWING APPROVAL STATUS			

A1

PROJECT: TRANSNET PIPELINES HOWICK
HW FIRE

TITLE: AS BUILT SITE LAYOUT

SCALE	CHECKED:	APPROVED:
As indicated	BJ	BJ
CAD FILE: HO1436-TPL_2024_09_0008_77334_RFP-FAT-0001	DESIGN-DRAWN: NP - NP	DATE: 2025-10-08
PROJECT No: 11364	DRAWING No: 11364-A1035	REV: A

GREYJONES (PTY) LTD.

(031) 816 9386 admin@greyjones.co.za www.greyjones.co.za

REFERENCES

DWG NUMBER	DESCRIPTION
-	-
-	-
-	-
-	-
-	-
-	-
-	-
-	-
-	-

REVISIONS

REV	DATE	BY	CHK	DESCRIPTION
A	2026-02-11	NP	BJ	ISSUED FOR ACCEPTANCE

TRANSNET pipelines

PROJECT NAME: HW FIRE

DRAWN		REF.	
TRACED		DATE	
CHECKED		APPROVED	
SCALE			
TPL DRAWING No.		REV	

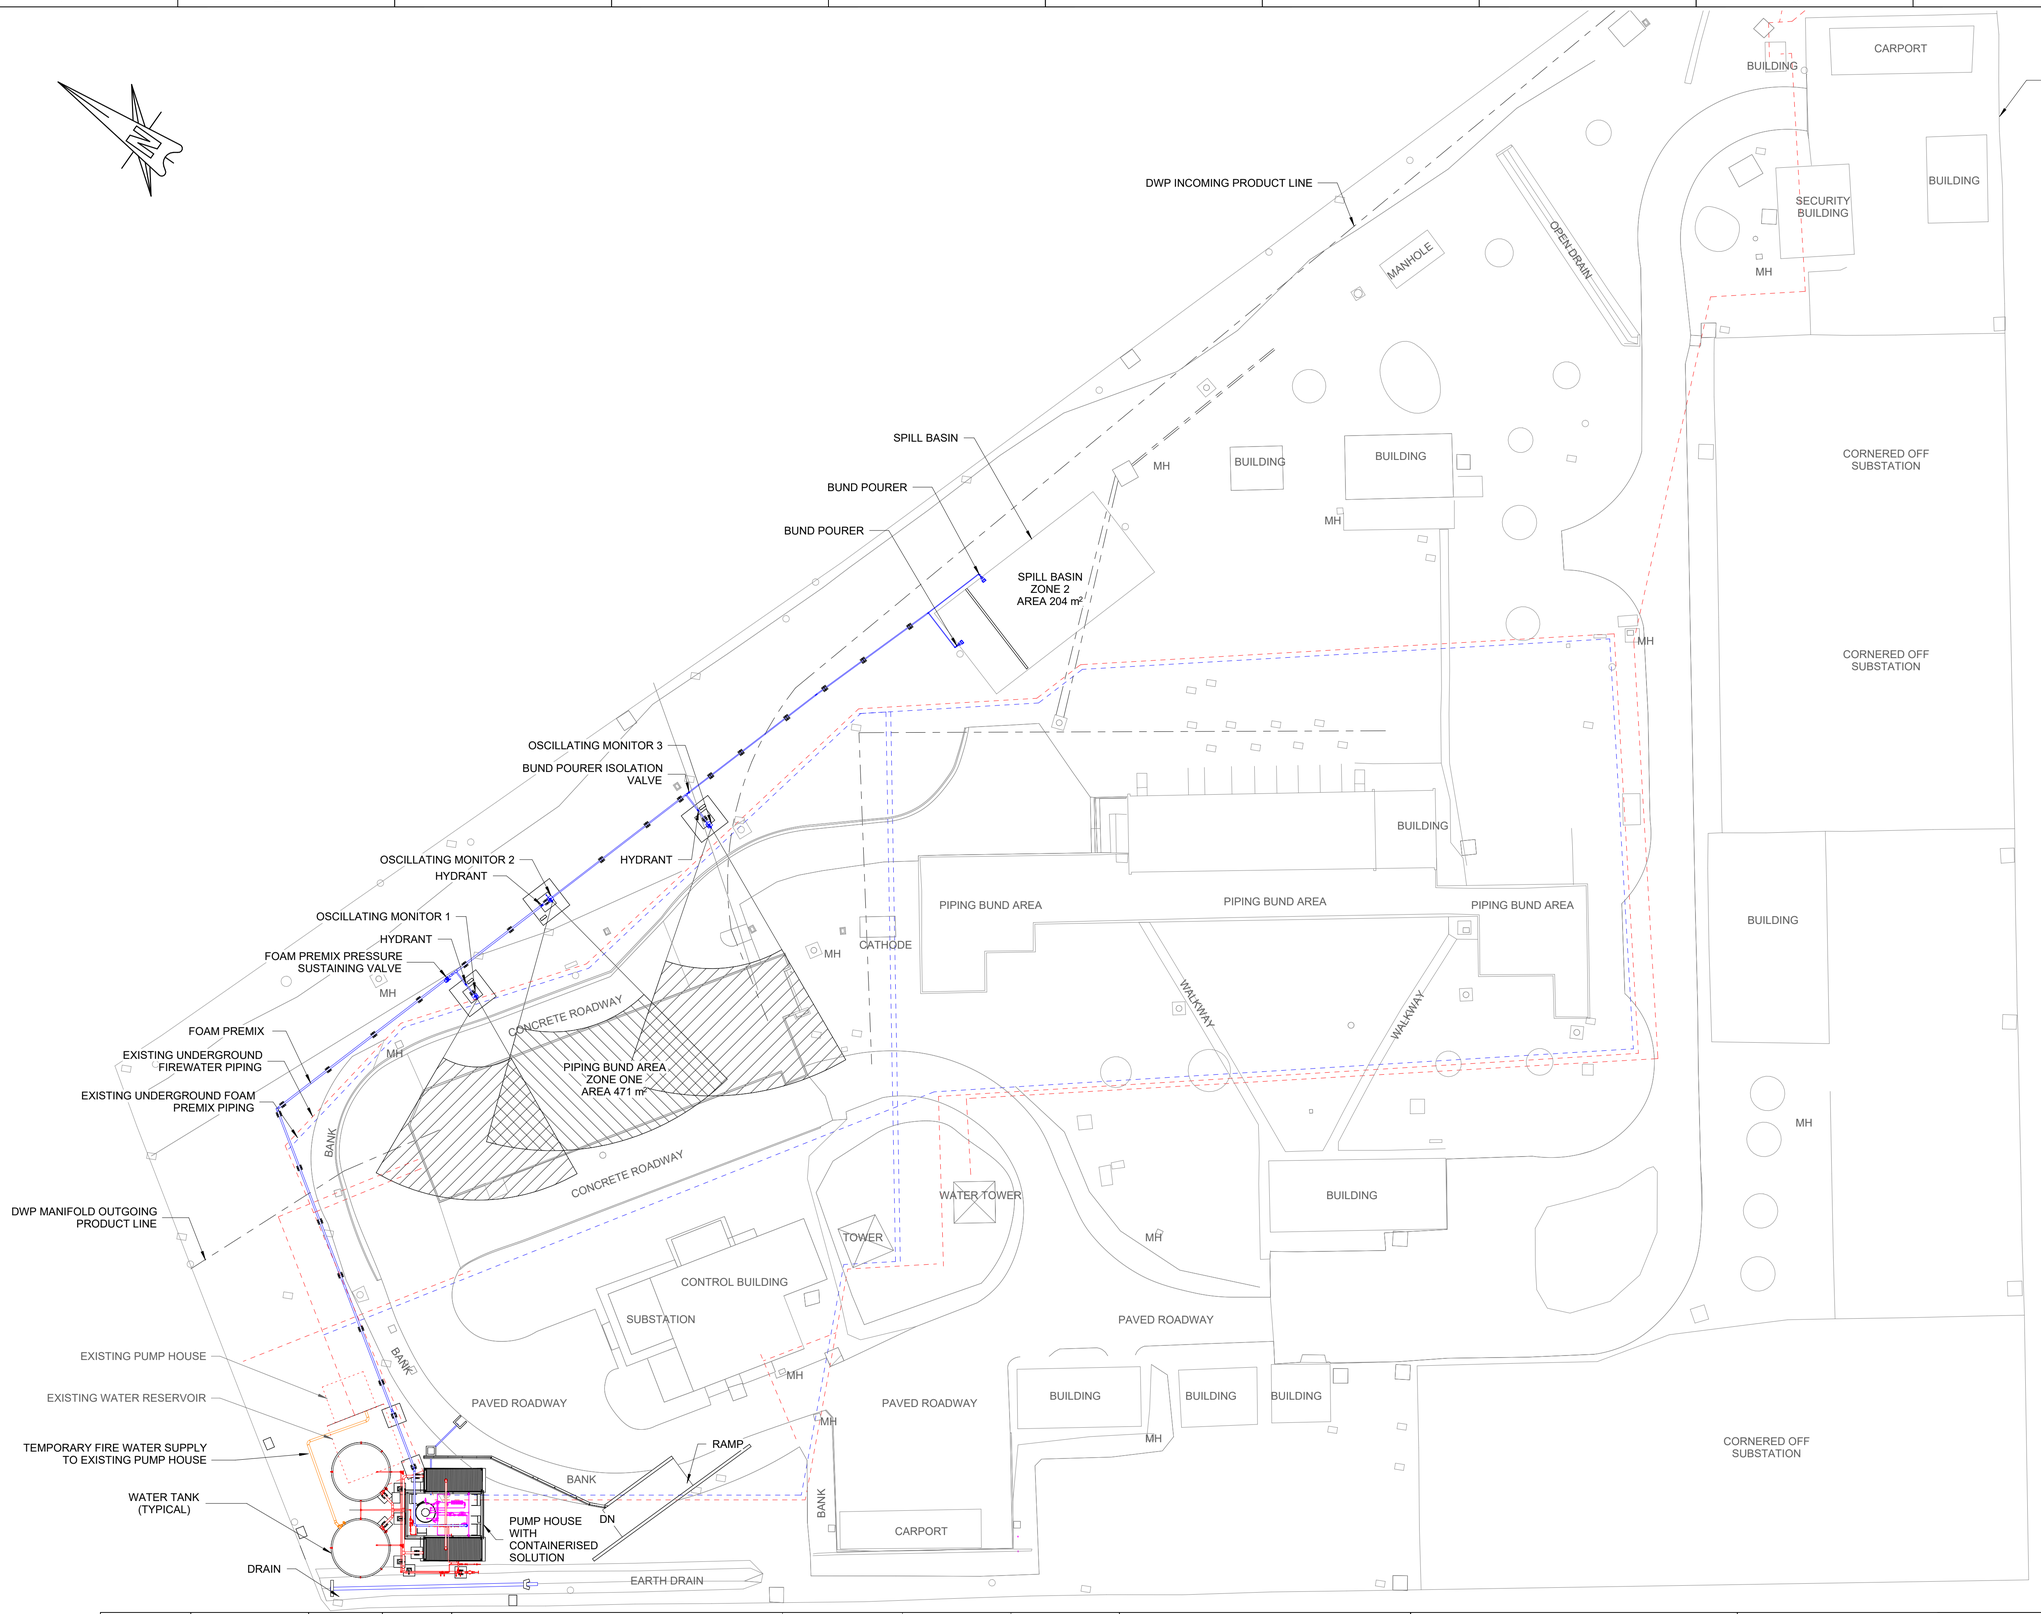

LEGEND

- UNDERGROUND PRODUCT PIPELINES
- EXISTING BUILDINGS TO BE DEMOLISHED
- EXISTING UNDERGROUND FIRE WATER PIPES
- EXISTING UNDERGROUND FOAM PREMIX PIPES

DESIGNER			
RESP. ENG			
PROJ. MANAGER			
CLIENT			
ROLE	NAME	SIGN	DATE
DRAWING APPROVAL STATUS			

A1

PROJECT: TRANSNET PIPELINES HOWICK HW FIRE

TITLE: SITE PLAN OF NEW FIRE PROTECTION SYSTEM

SCALE	CHECKED:	APPROVED:
As indicated	BJ	BJ
CAD FILE: HO1436-TPL_2024_09_0008_77334_RFP-FAT-0001	DESIGN-DRAWN: NP - NP	DATE: 2025-10-08
PROJECT No: 11364	DRAWING No: 11364-A1195	REV: A

GREYJONES (PTY) LTD.

(031) 816 9386 admin@greyjones.co.za www.greyjones.co.za

REFERENCES

DWG NUMBER	DESCRIPTION
-	-
-	-
-	-
-	-
-	-
-	-
-	-
-	-
-	-

REVISIONS

REV	DATE	BY	CHK	DESCRIPTION
A	2026-02-11	NP	BJ	ISSUED FOR ACCEPTANCE

TRANSNET pipelines

PROJECT NAME: HW FIRE

DRAWN		REF.	
TRACED		DATE	
CHECKED		APPROVED	
SCALE			
TPL DRAWING No.			REV