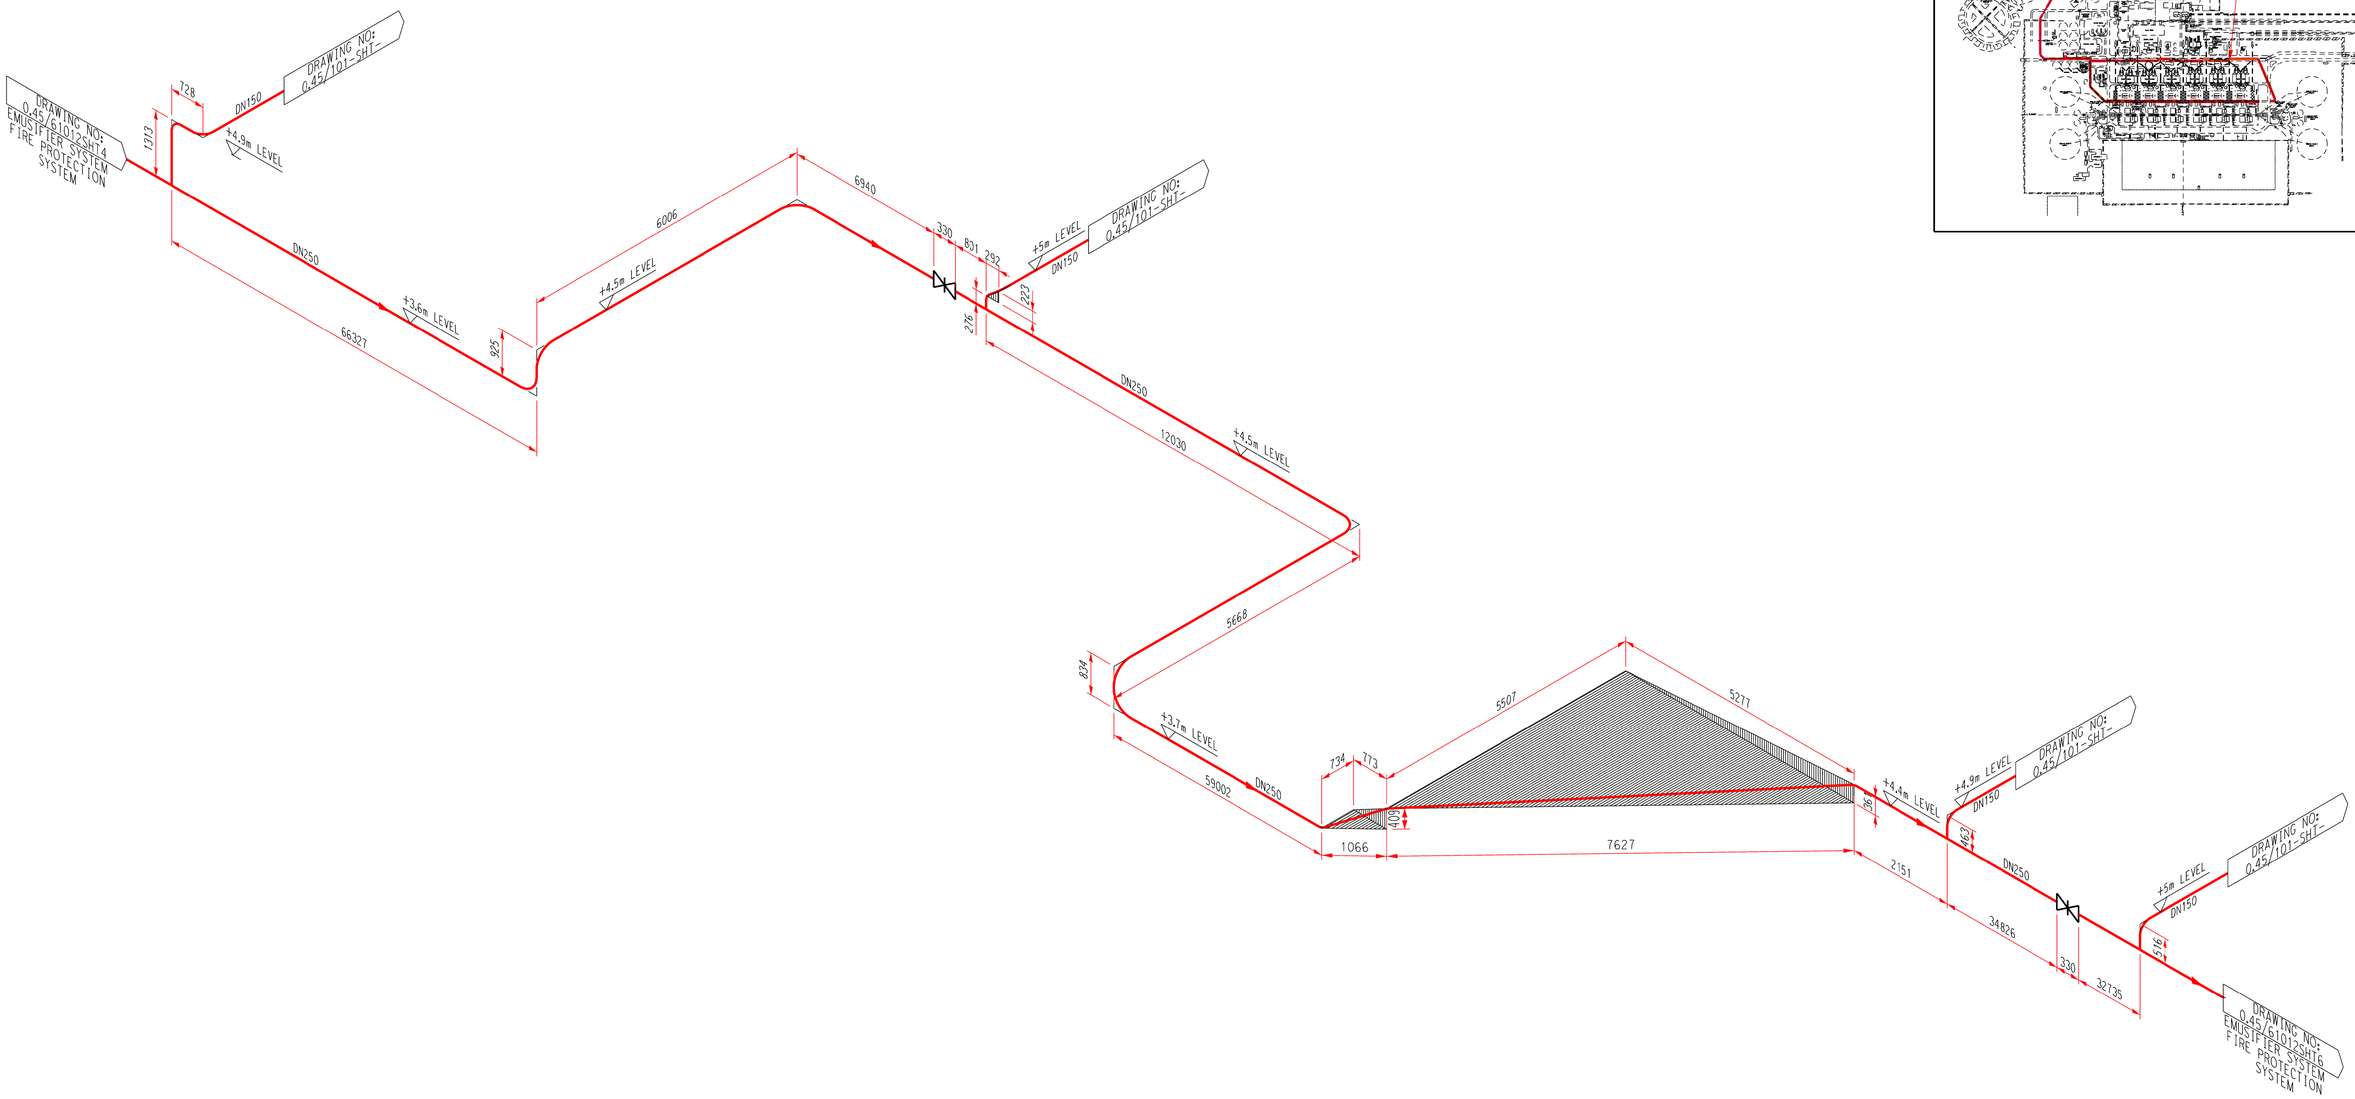

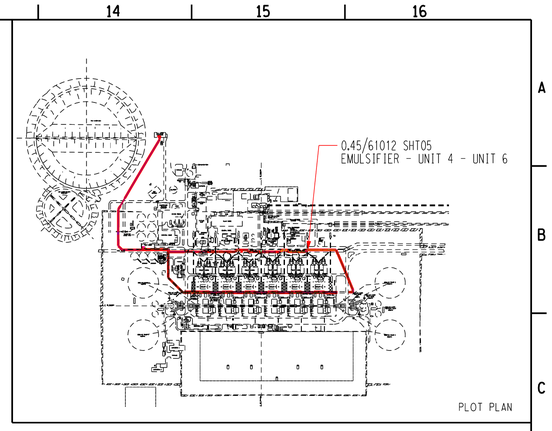

NOTES:
PUMP CENTRELINE FROM RAW WATER PUMP HOUSE
WILL BE USED AS Z-AXIS REFERENCE

REFERENCE DRAWINGS	
0.45/61012SHT4	EMUSIFIER FIRE PROTECTION SYSTEM
0.45/61012SHT6	EMUSIFIER FIRE PROTECTION SYSTEM

D.O.	REV	DATE	** REVISION **	REV BY	ChkD BY	KKS APPR	APPR BY	REFERENCE DRAWINGS
		- -						
		- -						
00	0	2024-06-24	AS-BUILT	EH	TS			

APPROVED BY:
INITIAL AND SURNAME:
PR ENG/PR TECH ENG No.:
DATE: - -
SIGNATURE:
CODIFICATION BY:
- -
CHECKED BY:
T SEHLARE 2024-06-24
CREATED BY:
E HLATSHWAYO 2024-06-24
SCALE NTS

CLASSIFICATION
PBS PATH

Eskom
ESKOM HOLDINGS SOC Ltd
REG No 2002/015527/30

KRIEL POWER STATION
ISOMETRIC DRAWING
FIRE PROTECTION SYSTEM
EMULSIFIER FIRE SYSTEM
UNIT 4 TO 6

ESKOM DRAWING No.	SHT	REV
0.45/61012	5	0

SIZE A1L

DRAWING CLASSIFICATION: CONTROLLED DISCLOSURE