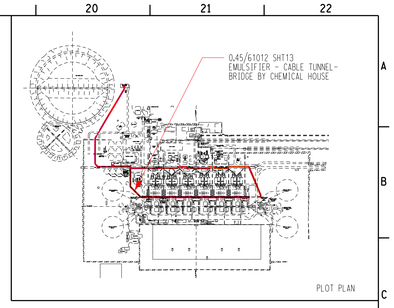

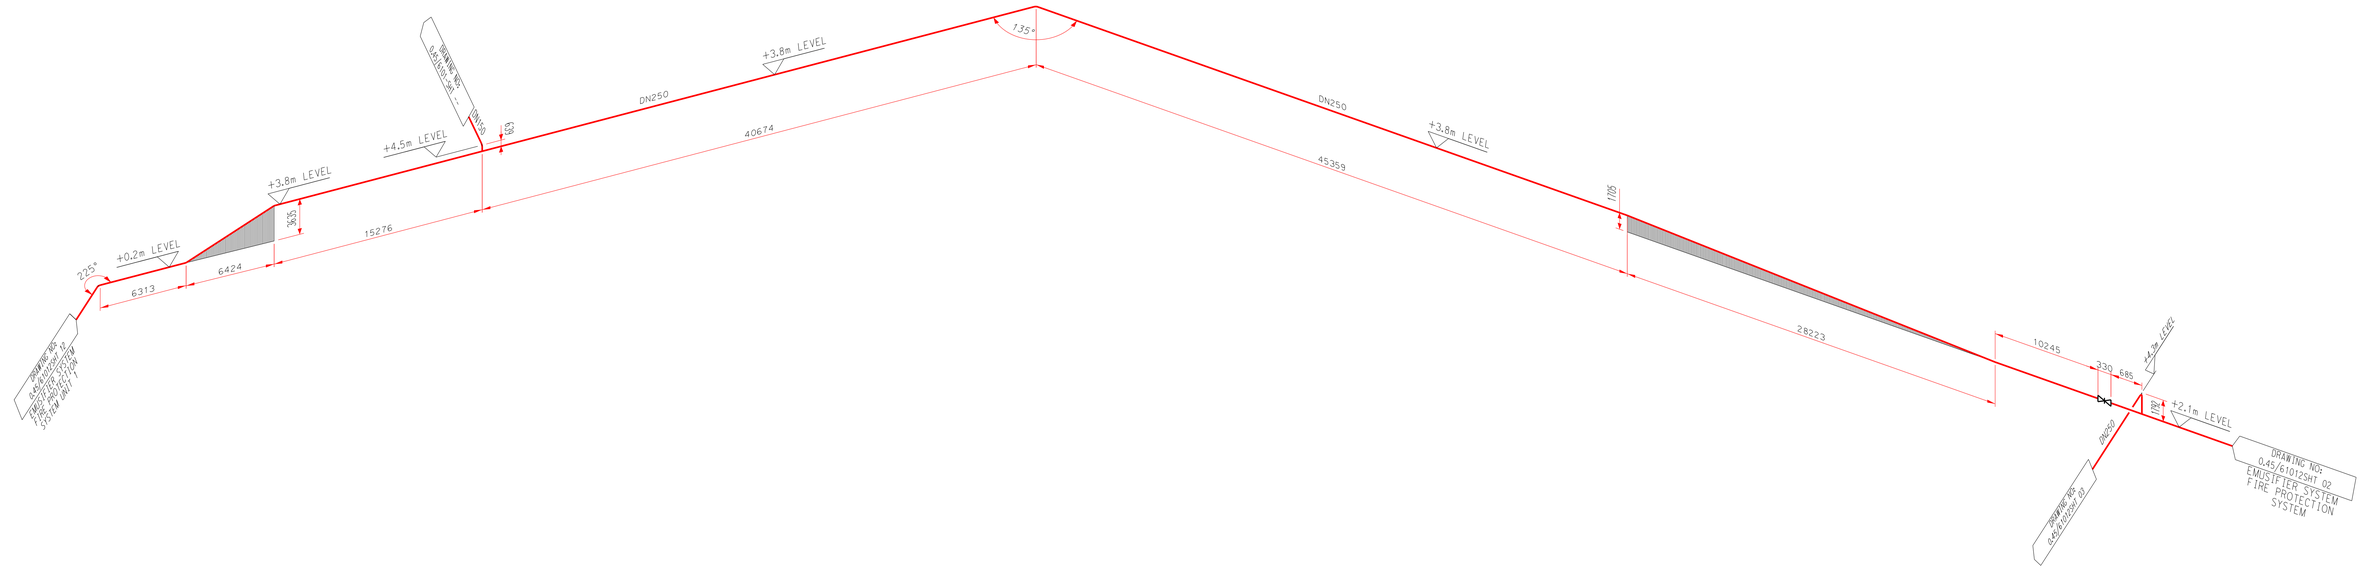

NOTES:
PUMP CENTRELINE WILL BE USED AS
Z-AXIS REFERENCE

D.O.	REV	DATE	** REVISION **	REV BY	CHKD BY	ENG APPD	MANR BY	REFERENCE DRAWINGS
		- -						
		- -						
DO	0	2024-06-24	AS-BUILT	EH	TS			

REFERENCE DRAWINGS	
0.45/61012SHT2	EMUSIFIER FIRE PROTECTION SYSTEM
0.45/61012SHT12	EMUSIFIER FIRE PROTECTION SYSTEM

APPROVED BY:
INITIAL AND SURNAME:
PR ENG/PR TECH ENG No:
DATE: - -
SIGNATURE:
CODIFICATION BY: - -
CHECKED BY: T SEHLARE 2024-06-24
CREATED BY: E HLATSHWAYO 2024-06-24
SCALE NTS

CLASSIFICATION
PBS PATH

Eskom
ESKOM HOLDINGS SOC LTD
REG No 2002/015527/30

KRIEL POWER STATION
ISOMETRIC DRAWING
FIRE PROTECTION SYSTEM
EMULSIFIER FIRE SYSTEM
CABLE TUNNEL TO BRIDGE BY CHEMICAL HOUSE

ESKOM DRAWING No: 0.45/61012 | SHT 13 | REV 0

DRAWING CLASSIFICATION: CONTROLLED DISCLOSURE

SIZE A0L