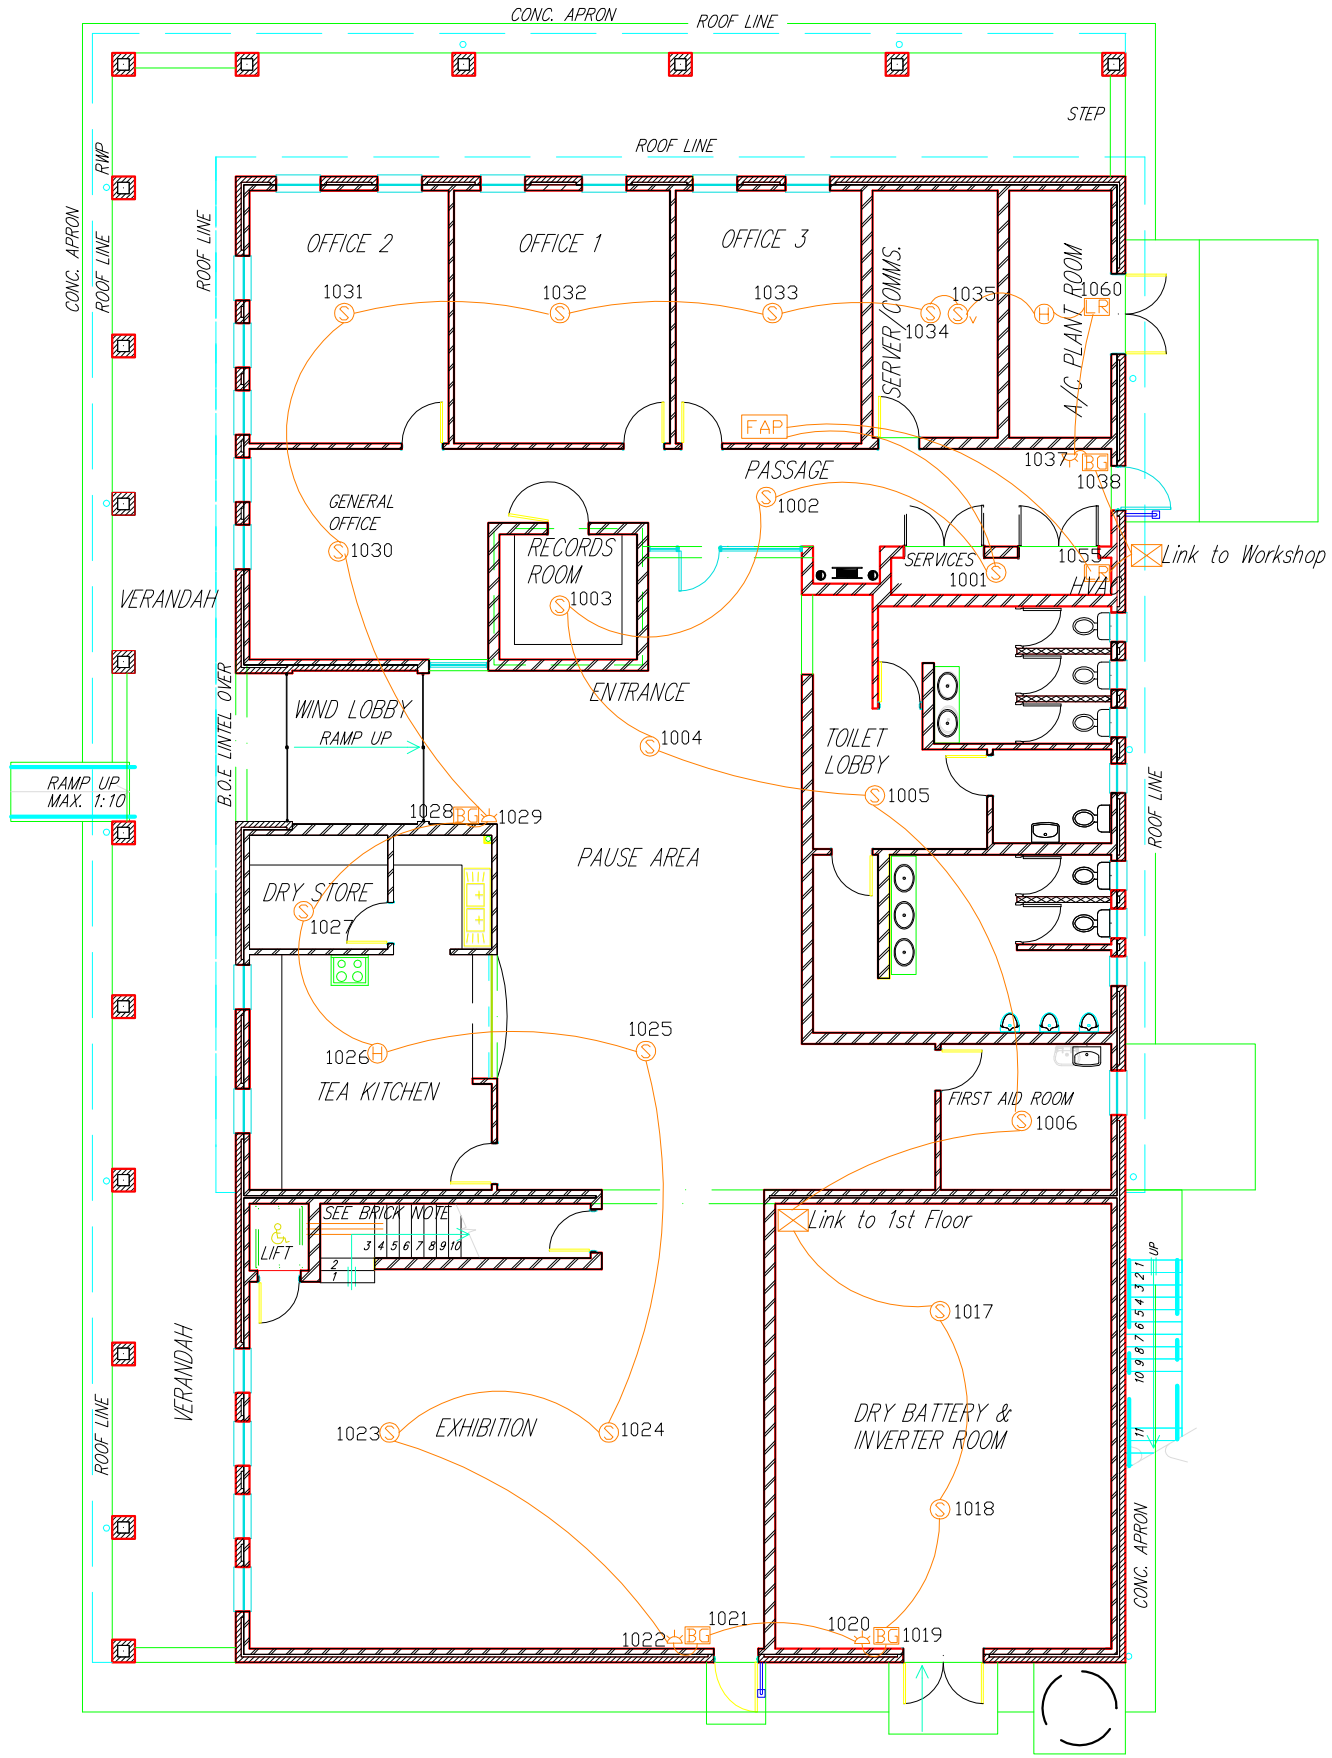

GENERAL NOTES : -

Non Visible PH30 Fire alarm will be strapped up in ceiling void.

Visible PH30 Fire alarm will be installed in 25mm PVC conduit. Conduits to manual call points will be surface mounted.

LEGEND

FAP	Fire Alarm Control Panel	
S	Optical smoke detector	
S_V	Optical smoke detector	server room floor void
H	Heat Sensor	
BG	Manual Call Point	
	Sounder Strobe	
BD	Beam Smoke Detector	
LR	Line Relay	
IO	Switch Monitor	

AS - BUILT

D.O.	REV	DATE		REV BY	CHKD BY	AUTH BY	KKS APP	
00	01	09-02-15	ISSUED FOR APPROVAL					
			** REVISION **					0.__ REFERENCE DRAWINGS
			INDEX REFERENCE : FIRE DETECTION					

DRG REGISTR		APPROVED BY :	
		AUTHORISED BY :	
KKS APP		ESKOM HOLDINGS LTD. REG. No. 2002/015527/06	
AUTH BY			
CHKD BY	09-02-15 NN		
DRAWN BY	09-02-15 NN		
SCALE	1:100		

SERE WIND ENERGY FACILITY
O&M OFFICES & VISITORS CENTRE
GROUND FLOOR FIRE DETECTION PLAN

Eskom

0.95/821-01-01

SPF CODE	SHEET	REV
___	01	01

SIZE GROOTTE A1L