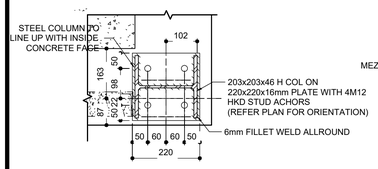

DETAIL 1
1 : 10

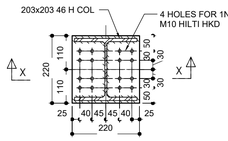

DETAIL 2
1 : 10

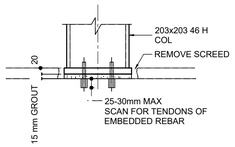

SECTION X-X
1 : 10

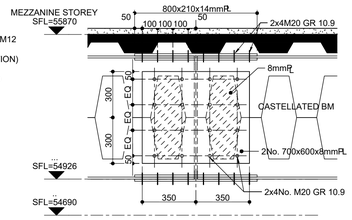

TYPICAL JOINING DETAIL (CASTELLATED BEAM)

SECTION 3-3
1 : 20

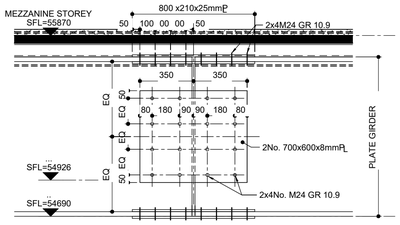

TYPICAL JOINING DETAIL (PLATE GIRDER)

SECTION 4-4
1 : 20

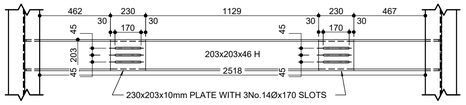

DETAIL 5
1 : 20

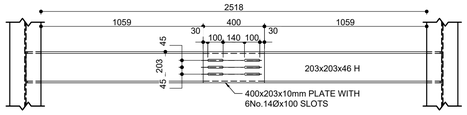

DETAIL 6
1 : 20

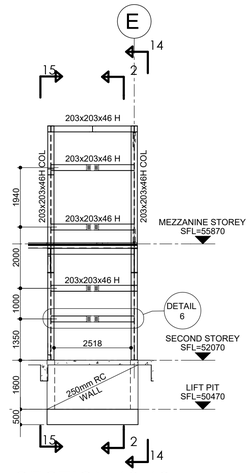

SECTION 12-12
1 : 100

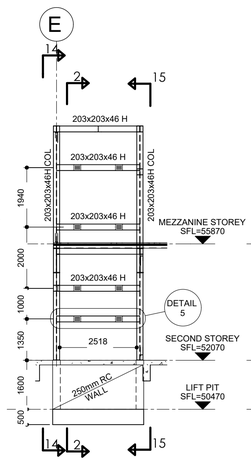

SECTION 13-13
1 : 100

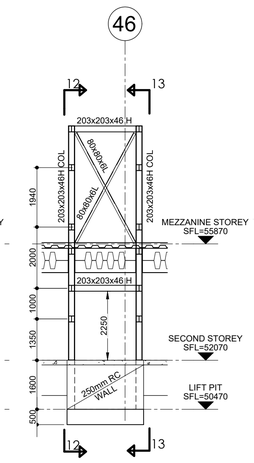

SECTION 14-14
1 : 100

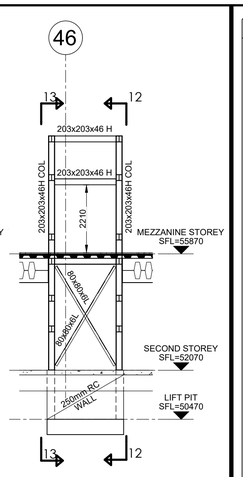

SECTION 15-15
1 : 100

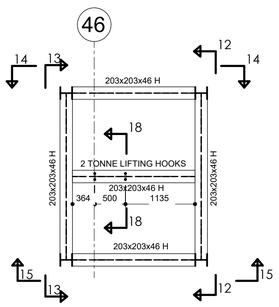

SECTION 1-1
1 : 50

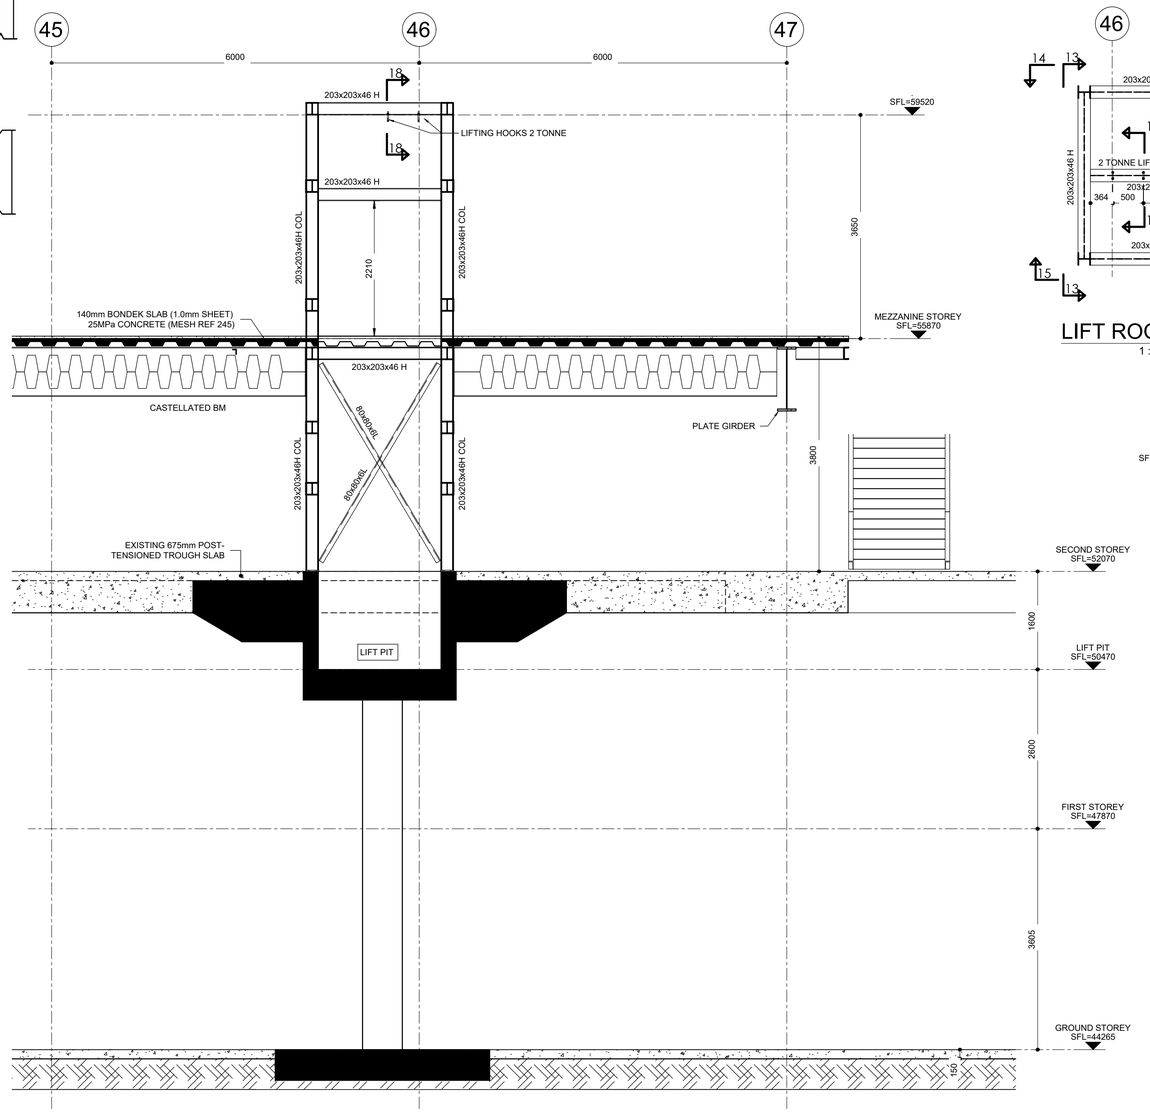

SECTIONAL ELEVATION 2-2
1 : 50

LIFT ROOF PLAN
1 : 50

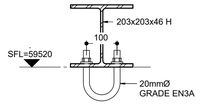

SECTION 18-18
1 : 10

NOTES

THIS DRAWING TO BE READ IN CONJUNCTION WITH ALL RELEVANT ARCHITECTS & CONSULTANTS DRAWINGS & SPECIFICATIONS

FOR GENERAL NOTES REFER DRAWING A.509-28/01

AS BUILT

THIS AS BUILT DRAWING REFLECTS THE INFORMATION ON THE FINAL DESIGN DRAWING AND CHANGES / ADDITIONS ISSUED BY SITE INSTRUCTION. THIS DRAWING DOES NOT INCORPORATE ANY ON SITE 'AS BUILT' MEASUREMENTS

AMENDMENTS

Z	JAN 2019	JKW	AS BUILT
B	27/03/18	JKW	LIFT STEEL MEMBERS AMENDED, PLANS, SECTIONS & DETAILS ADDED
A	16/02/18	JKW	FOR CONSTRUCTION

DESIGNED	DRAWN	CHECKED
BS	BS	RGD Pr.Eng.

CAPE TOWN INTERNATIONAL AIRPORT
AIRPORTS COMPANY SOUTH AFRICA

INTERNATIONAL DEPARTURES TERMINAL: CENTRAL BUSINESS LOUNGE

SECTIONS & DETAILS

KFD WILKINSON
CONSULTING ENGINEERS
12TH FLOOR PICBEL PARKADE STRAND STREET CAPE TOWN 8001
P.O. BOX 3276 CAPE TOWN 8000
TEL (021) 425-1610 FAX (021) 425-1649 E-MAIL admin@kfdw.co.za

SCALE	DWG. NO.	REV
AS SHOWN	A.509-28/05	Z