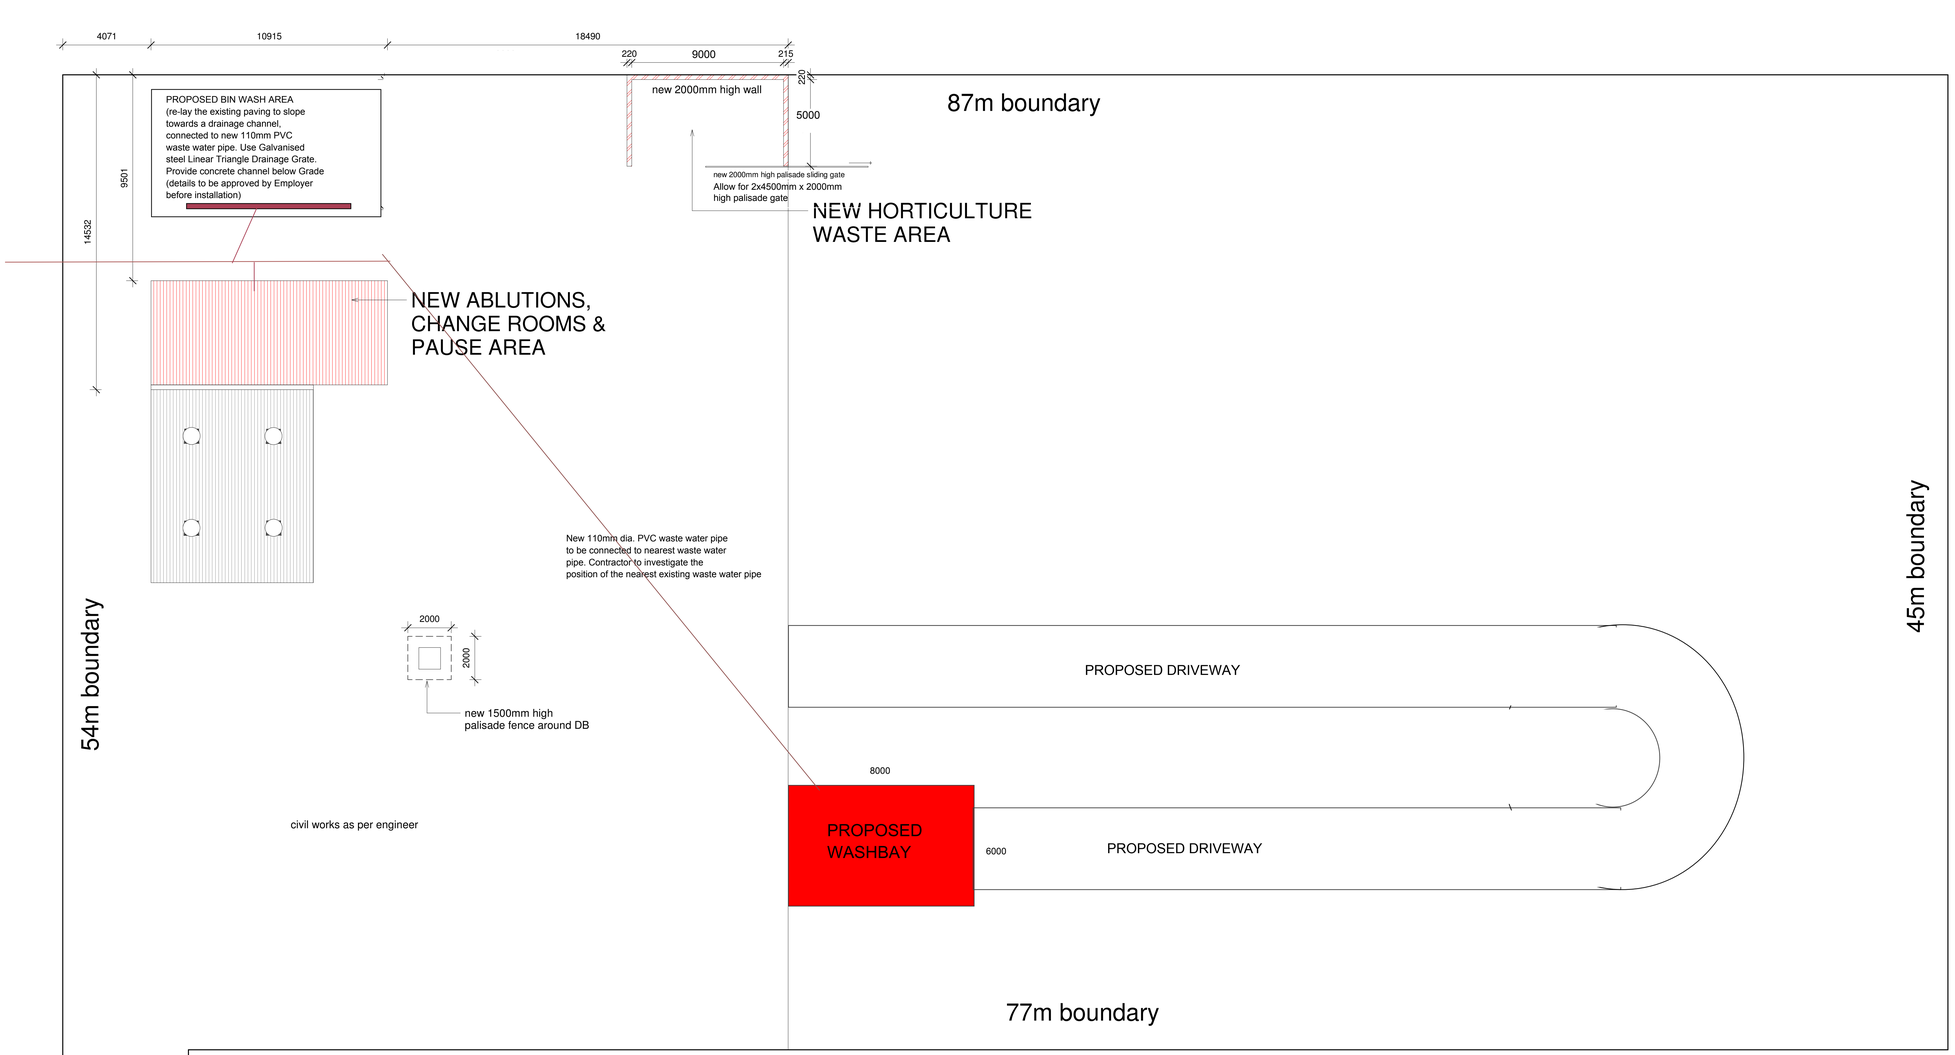

06 Site
1 : 100

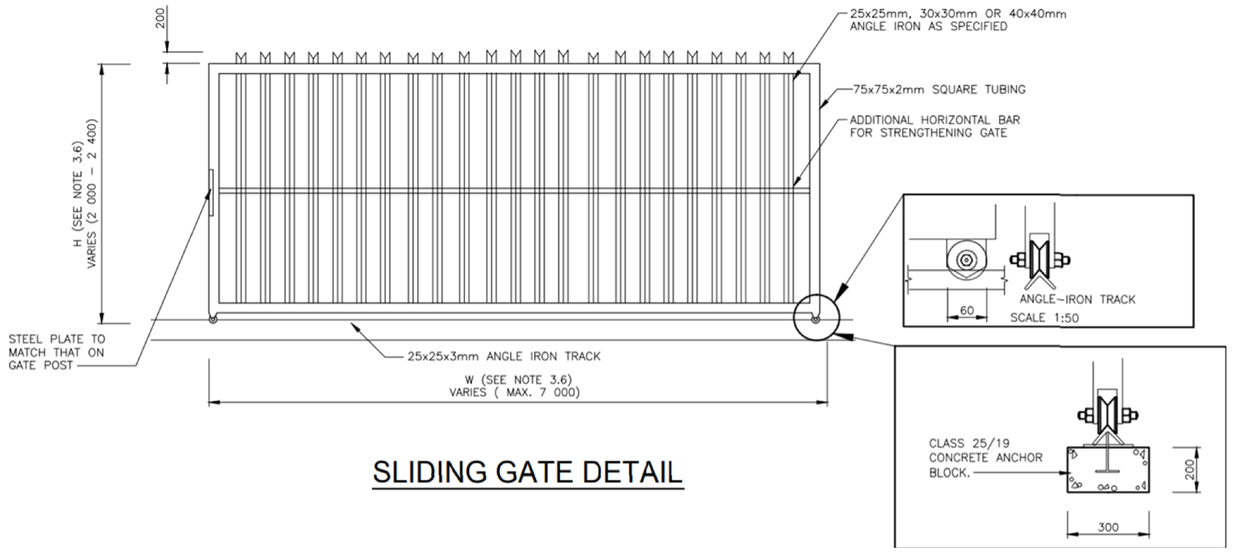

SLIDING GATE DETAIL

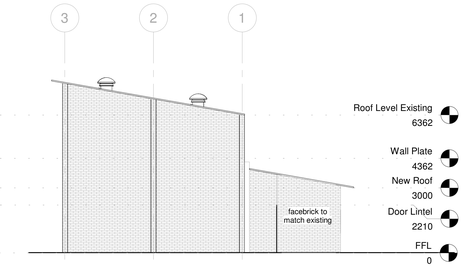

07 East Elevation
1 : 100

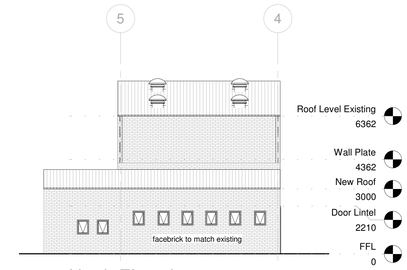

08 North Elevation
1 : 100

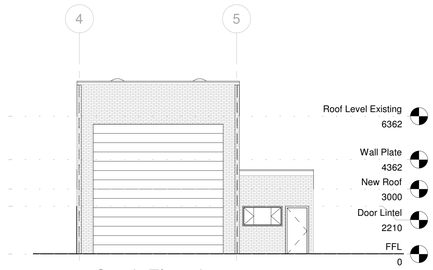

09 South Elevation
1 : 100

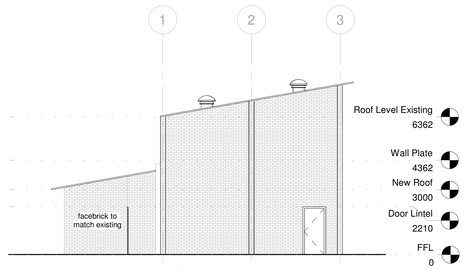

10 West Elevation
1 : 100

REV	REVISION DESCRIPTION	BY	CHKD	AUTH	DATE
	REVISED_DRAWINGS	AM			05/03/2021
_0_	FIRST_ISSUE	AM			19/12/2020

Eskom

____REFUSE_WAREHOUSE_EAL_

AS BUILT_AND NEW ADDITION

AUTH:
DATE:
CHKD:
DATE:
DRAWN: AM
DATE: 05/03/2021

SCALE : 1 AS INDICATED

THIS DRAWING IS THE PROPERTY OF ESKOM

__-GP-_

SET	SHEET	REVISION
_01	_01	__0